C. PROPOSED 10' EASEMENT TO ENCOMPASS OVERHEAD AND UNDERGROUND UTILITY WIRES SERVING THE BUILDING ON THE SUBJECT PARCEL THAT ENCROACH ONTO 20-26 QUIRK

WERE LOCATED IN THE FIELD ON THE DATE OF THE SURVEY. NO KNOWLEDGE OF WHO

ZONING INFORMATION SHOWN HEREON IS TAKEN FROM RECORD PLANS, DEEDS AND TOWN

INCLUDING PIPE INVERT, PIPE MATERIAL, AND PIPE SIZE, WAS OBSERVED AND MEASURED AT FIELD LOCATED STRUCTURES (MANHOLES/CATCH BASINS, ETC). CONDITIONS CAN VARY FROM THOSE ENCOUNTERED AT THE TIMES WHEN AND LOCATIONS WHERE DATA IS OBTAINED. DESPITE MEETING THE REQUIRED STANDARD OF CARE, THE SURVEYOR CANNOT, AND DOES NOT WARRANT THAT PIPE MATERIAL AND/OR PIPE SIZE THROUGHOUT THE PIPE RUN ARE THE SAME AS THOSE OBSERVED AT EACH STRUCTURE, OR THAT THE PIPE RUN IS STRAIGHT BETWEEN THE LOCATED STRUCTURES.

12. NO UNDERGROUND STRUCTURES WERE ENTERED AS PART OF THIS SURVEY.

13. ADDITIONAL UTILITY (WATER, GAS, ELECTRIC ETC ...) DATA MAY BE SHOWN FROM FIELD LOCATED SURFACE MARKINGS, EXISTING STRUCTURES, AND/OR EXISTING DRAWINGS.

14. UNLESS SPECIFICALLY NOTED HEREON, THE SURVEYOR HAS NOT EXCAVATED TO PHYSICALLY LOCATE THE UNDERGROUND UTILITIES. THE SURVEYOR MAKES NO GUARANTEES THAT THE SHOWN UNDERGROUND UTILITIES ARE EITHER IN SERVICE, ABANDONED OR SUITABLE FOR USE, NOR ARE IN THE EXACT LOCATION OR CONFIGURATION INDICATED HEREON.


15. ALL BUILDINGS AND STRUCTURES WERE LOCATED AND MEASURED AT GROUND LEVEL. THE SURVEYOR MAKES NO DETERMINATIONS OR GUARANTEES AS TO THE ABSENCE, EXISTENCE OR LOCATION OF UNDERGROUND STRUCTURES, FOUNDATIONS, FOOTINGS, PROJECTIONS, WALLS, TANKS, SEPTIC SYSTEMS, ETC. NO TEST PITS, EXCAVATIONS OR GROUND PENETRATING RADAR WERE PERFORMED AS PART OF THIS SURVEY.

16. PRIOR TO ANY DESIGN OR CONSTRUCTION, THE PROPER UTILITY AGENCIES MUST BE CONTACTED FOR VERIFICATION OF UTILITY TYPE AND FOR FIELD LOCATIONS. UNLESS NOTED BELOW, SUPPLEMENTAL DOCUMENTS WERE NOT USED TO COMPILE THE SUBSURFACE UTILITY INFORMATION SHOWN HEREON.

THIS SURVEY IS NOT VALID WITHOUT THE EMBOSSED OR INKED SEAL OF THE PROFESSIONAL.

TO MY KNOWLEDGE AND BELIEF THIS MAP IS SUBSTANTIALLY CORRECT AS NOTED HEREON.

ROBERT MIGLIORE/LS CONNECTICUT LICENSE No. 70217

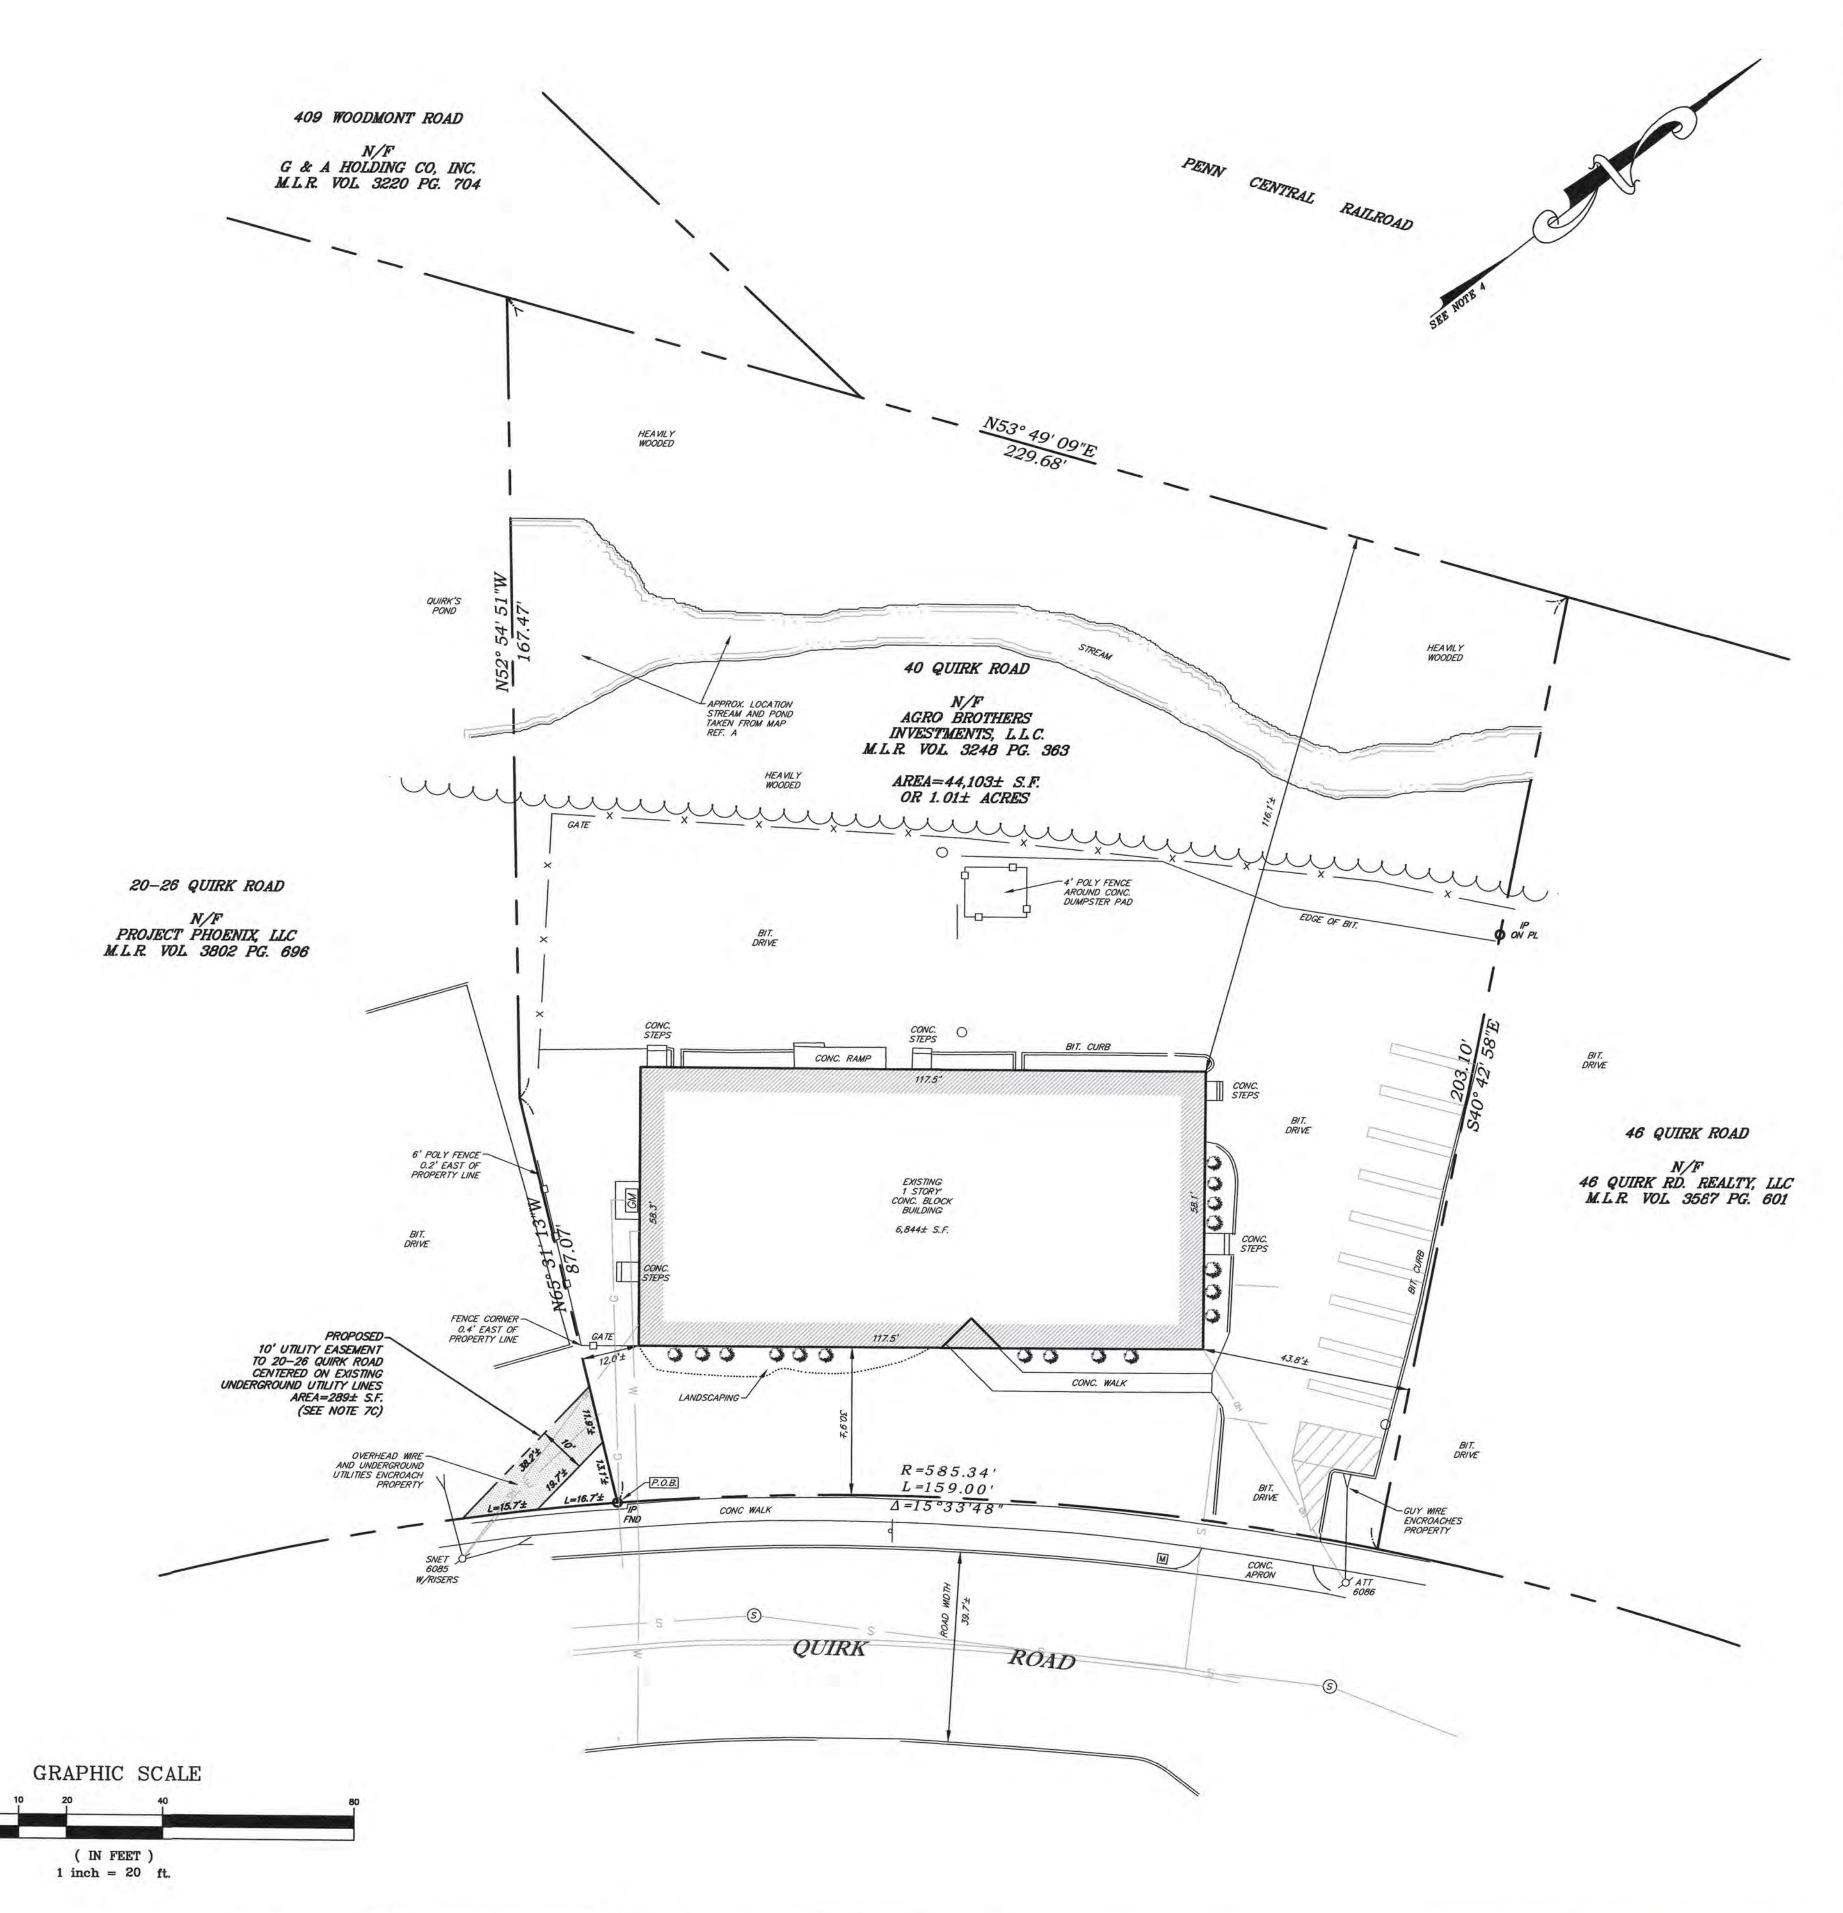

VICINITY MAP $(1"=1,000'\pm)$

MAP REFERENCES

A. MAP ENTITLED "ZONING LOCATION SURVEY NEW ENGLAND SCHOOL OF MONTESSORI #40 QUIRK ROAD MILFORD, CONNECTICUT MAP 91, BLOCK 706, PARCEL 2X" SCALE 1"=20' DATED 1/13/09 BY WESTCOTT AND MAPES, INC.

B. MAP ENTITLED "PLOT PLAN #40 QUIRK ROAD MILFORD, CONNECTICUT PARCEL 2X, BLOCK 706, MAP 91" SCALE 1"=20' DATED 5/29/08 BY WESTCOTT AND MAPES,

C. MAP ENTITLED "PROPOSED SUBDIVISION MAP QUIRK CENTER AN INDUSTRIAL SUBDIVISION MILFORD, CONN" SCALE 1"=40' DATED JULY 6, 1976 BY DANIEL B.

D. MAP ENTITLED "MAP SHOWING REVISED LOT LINES 4 & 5 QUIRK ROAD MILFORD, CONNECTICUT" SCALE 1"=40' REVISED TO 3-25-83 BY SPATH-BJORKLUND ASSOCIATES, INC. MAP AB 1152

E. MAP ENTITLED "COMPILATION PLAN TOWN OF MILFORD MAP SHOWING LAND RELEASED TO GARY D. BECROFT BY THE STATE OF CONNECTICUT DEPARTMENT OF RANSPORTATION NEW HAVEN MAINLINE RAILROAD VICINITY OF WOODMONT ROAD: SCALE 1"=80' DATED MAY, 2005. MAP AB 3217

F. MAP ENTITLED "FIRM FLOOD INSURANCE RATE MAP NEW HAVEN COUNTY, CONNECTICUT (ALL JURISDICTIONS)" PANEL 433532 OF 635 MAP NUMBER 09009C0532J REVISED JULY 8, 2013."

> THE INFORMATION CONTAINED HEREIN IS THE PROPRIETARY AND CONFIDENTIAL PROPERTY OF WESTCOTT AND MAPES, INC. REPRODUCTIONS, PUBLICATION, DISTRIBUTION OR DUPLICATION IN WHOLE OR IN PART REQUIRES THE WRITTEN PERMISSION OF WESTCOTT AND MAPES, INC. THIS DOCUMENT AND COPIES THEREOF ARE VALID ONLY IF THEY BEAR THE LIVE SIGNATURE AND SEAL OF THE DESIGNATED LICENSED PROFESSIONAL. UNAUTHORIZED USE, DISTRIBUTION AND/OR DUPLICATION OF SAID INFORMATION WILL RESULT IN SUBSTANTIAL DAMAGE TO WESTCOTT AND MAPES, INC. FOR WHICH YOU MAY BE LIABLE.

Revisions Project Title Date Description

PROPERTY OF AGRO BROTHERS INVESTMENTS, L.L.C. 40 QUIRK ROAD MILFORD, CONNECTICUT



142 Temple Street New Haven, CT 06510 TEL (203) 789-1260 · FAX (203) 789-8261 E-mail address: westcottandmapes@snet.net



PROPERTY SURVEY

Pote 9/17/2019 Scale 1" = 20' 20-512-00 Project No. 2051200base.dwg

ZONE TABLE ZONE LI - LIMITED INDUSTRIAL DISTRICT

Section No.	Description	Required	Existing	Proposed	Comment
3.10.2	Special Uses				
3.10.2.7	Other related or equivalent principal buildings or uses, which are not specifically listed and are not prohibited may be permitted by the Board by Special Exception in accordance with Section 7.3.		_	Dog daycare facility	Complies (*)
3.10.3	Accessory Uses				
3.10.3.2	Other accessory buildings or uses which are clearly subordinate and customarily incidental to and located on the same lot with the principal use; provided that such accessory building or use will not be dangerous, injurious, detrimental or objectionable to the public health, safety or welfare of the neighborhood or community.			Outdoor play area/dog run	Complies (*)
3.10.4	Lot and Building Requirements				and the same and t
3.10.4.1	Minimum Lot Requirements				
	(1) Lot Area	10,000 s.f.	44,103 s.f.	44,103 s.f.	Complies
	(2) Lot Width	50 ft.	167± ft.	167± ft.	Complies
	(3) Lot Depth	100 ft.	221± ft.	221± ft.	Complies
3.10.4.2	Minimum Yard and Open Space Required				
	(1) Principal Uses				
	(a) Front Yard	20 ft.	32.5 ft.	32.5 ft.	Complies
	(b) Side	0 ft. (10 ft. if provided)	12.0 ft.	12.0 ft.	Complies
	(c) Rear Yards	0 ft. (20 ft. if provided)	116.0 ft.	116.0 ft.	Complies
	(2) Accessory Buildings	·			N/A
	(3) Accessory Uses	No parking or loading areas in the min. req. front yard		_	Exist. conditions
	(4)	Buffer Strip: An adequate buffer strip shall be provided adjacent to any Residential District.	-	_	N/A
	(5)	Landscaping: The front yard shall be appropriately landscaped except for required access ways. This landscaping shall be in accordance with Article V, Section 5.14.	_	_	Exist. conditions
3.10.4.3	Building requirements				Complies
	(1) Design	In harmony with neighborhood	-	_	Complies
	(2) Length	Not unreasonable	117.5 ft.	117.5 ft.	Complies
	(3) Height	35 ft. maximum	20± ft.	20± ft.	Complies
	(4) Spacing	1/2 the sum of the heights	N/A	N/A	N/A
	(5) Building Area	50% Maximum	15.5%	15.5%	Complies
	(6) Floor Area Ratio	1.0 Maximum	0.15	0.15	Complies

NOTE


* DEFER TO LEGAL COUNSEL/ZONING APPROVAL OF PROPOSED USE.

GENERAL NOTES

- 1. THE SUBJECT PROPERTY IS LOCATED AT 40 QUIRK ROAD, MILFORD, CONNECTICUT. THE BACKGROUND CONDITIONS SHOWN HERE—ON ARE FROM A MAP ENTITLED "PROPERTY OF AGRO BROTHERS INVESTMENTS,LLC, 40 QUIRK ROAD, MILFORD, CONNECTICUT, PROPERTY SURVEY, SHEET 1 OF 1, SCALE 1"=20', DATED 09/17/2—19" PREPARED BY WESTCOTT AND MAPES, INC.
- 2. THE PURPOSE OF THE PLAN SET IS TO PROVIDE BASIC SITE, ZONING INFORMATION FOR MUNICIPAL OFFICIAL'S REVIEW.
- 3. THE CONTRACTOR SHALL MAINTAIN ALL OF HIS OPERATIONS AND WORK WITHIN THE LIMITS OF THE PROPERTY.
- 4. THE CONTRACTOR SHALL FAMILIARIZE HIMSELF WITH THE SITE CONDITIONS AND PERFORM FIELD INVESTIGATIONS PRIOR TO COMMENCING HIS WORK.
- 5. THE CONTRACTOR SHALL INSTALL AND MAINTAIN TEMPORARY EROSION AND SEDIMENTATION CONTROL MEASURES WHERE APPLICABLE IN ACCORDANCE WITH THE STATE OF CONNECTICUT GUIDELINES FOR SOIL EROSION AND SEDIMENT CONTROL MANUAL, LATEST EDITION.
- 6. THE CONTRACTOR SHALL CONTACT "CALL BEFORE YOU DIG" 811" AT LEAST SEVENTY-TWO (72) HOURS PRIOR TO COMMENCING WORK.
- 7. EXISTING UTILITIES MAY BE SHOWN ACCORDING TO REFERENCE PLANS WHEN AVAILABLE, SKETCHES, TESTIMONY AND/OR FIELD EVIDENCE AND MUST BE CONSIDERED APPROXIMATE IN NATURE. THE CONTRACTOR SHALL CONFIRM ACTUAL LOCATIONS AND ELEVATIONS OF EXISTING UTILITIES IF AND WHERE NECESSARY. THERE MAYBE OTHER UTILITIES THAT EXIST NOT SHOWN AND UNKNOWN TO THE AUTHOR OF THESE PLANS.
- 8. THE CONTRACTOR IS RESPONSIBLE FOR COORDINATING ALL WORK REGARDING THIS PROJECT AND FOR OBTAINING ANY NECESSARY PERMITS RELATED TO HIS CONSTRUCTION ACTIVITIES.
- 9. THE CONTRACTOR SHALL BE RESPONSIBLE FOR ESTABLISHING AND MAINTAINING A SAFE ENVIRONMENT FOR WORKERS, PEDESTRIANS AND VEHICULAR TRAFFIC THROUGHOUT THE CONSTRUCTION PERIOD, AND COORDINATE HIS EFFORTS AND HIS SEQUENCE AND TIMING OF OPERATIONS WITH THE PROPERTY OWNER.
- 10. THE CONTRACTOR IS RESPONSIBLE FOR THE PROPER DEMOLITION, REMOVAL, AND OFF-SITE DISPOSAL OF EXISTING FEATURES, WITHIN THE LIMITS OF WORK, AS REQUIRED FOR THE INSTALLATION OF NEW WORK.
- 11. UNLESS OTHERWISE SPECIFIED, THE METHODS AND MATERIALS FOR THIS PROJECT SHALL CONFORM TO THE CONNECTICUT DOT STANDARD SPECIFICATIONS FOR ROADS, BRIDGES AND INCIDENTAL CONSTRUCTION FORM 817 AND AS AMENDED.
- 12. SANITARY SEWER SERVICE PIPES DEPICTED ON THIS PLAN WERE DIGITIZED FROM THE FIELD TIES SKETCH PROVIDED BY THE CITY OF MILFORD ENGINEERING DEPARTMENT, PERMIT #19559, PERFORMED BY T. COLLUCCI CONST., ROBERT SALEY INSPECTOR DATED NOVEMBER 28, 2008. SEWER MAP S 1126.

THE INFORMATION CONTAINED HEREIN IS THE PROPRIETARY AND CONFIDENTIAL PROPERTY OF WESTCOTT AND MAPES, INC. REPRODUCTIONS, PUBLICATION, DISTRIBUTION OR DUPLICATION IN WHOLE OR IN PART REQUIRES THE WRITTEN PERMISSION OF WESTCOTT AND MAPES, INC. THIS DOCUMENT AND COPIES THEREOF ARE VALID ONLY IF THEY BEAR THE LIVE SIGNATURE AND SEAL OF THE DESIGNATED LICENSED PROFESSIONAL. UNAUTHORIZED USE, DISTRIBUTION AND/OR DUPLICATION OF SAID INFORMATION WILL RESULT IN SUBSTANTIAL DAMAGE TO WESTCOTT

AND MAPES, INC. FOR WHICH YOU MAY BE LIABLE.

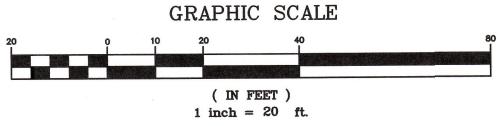


|01/29/20| REVS. TO FENCES AND DOORS PER ARCHT.

4 04/29/20 ADDED CURB LABELS & SAN. SEWER SKETCH

3\ 03/17/20 REV. EX. SAN. AND ADDED NOTES

03/02/20 REV. PROP. FENCE HT.

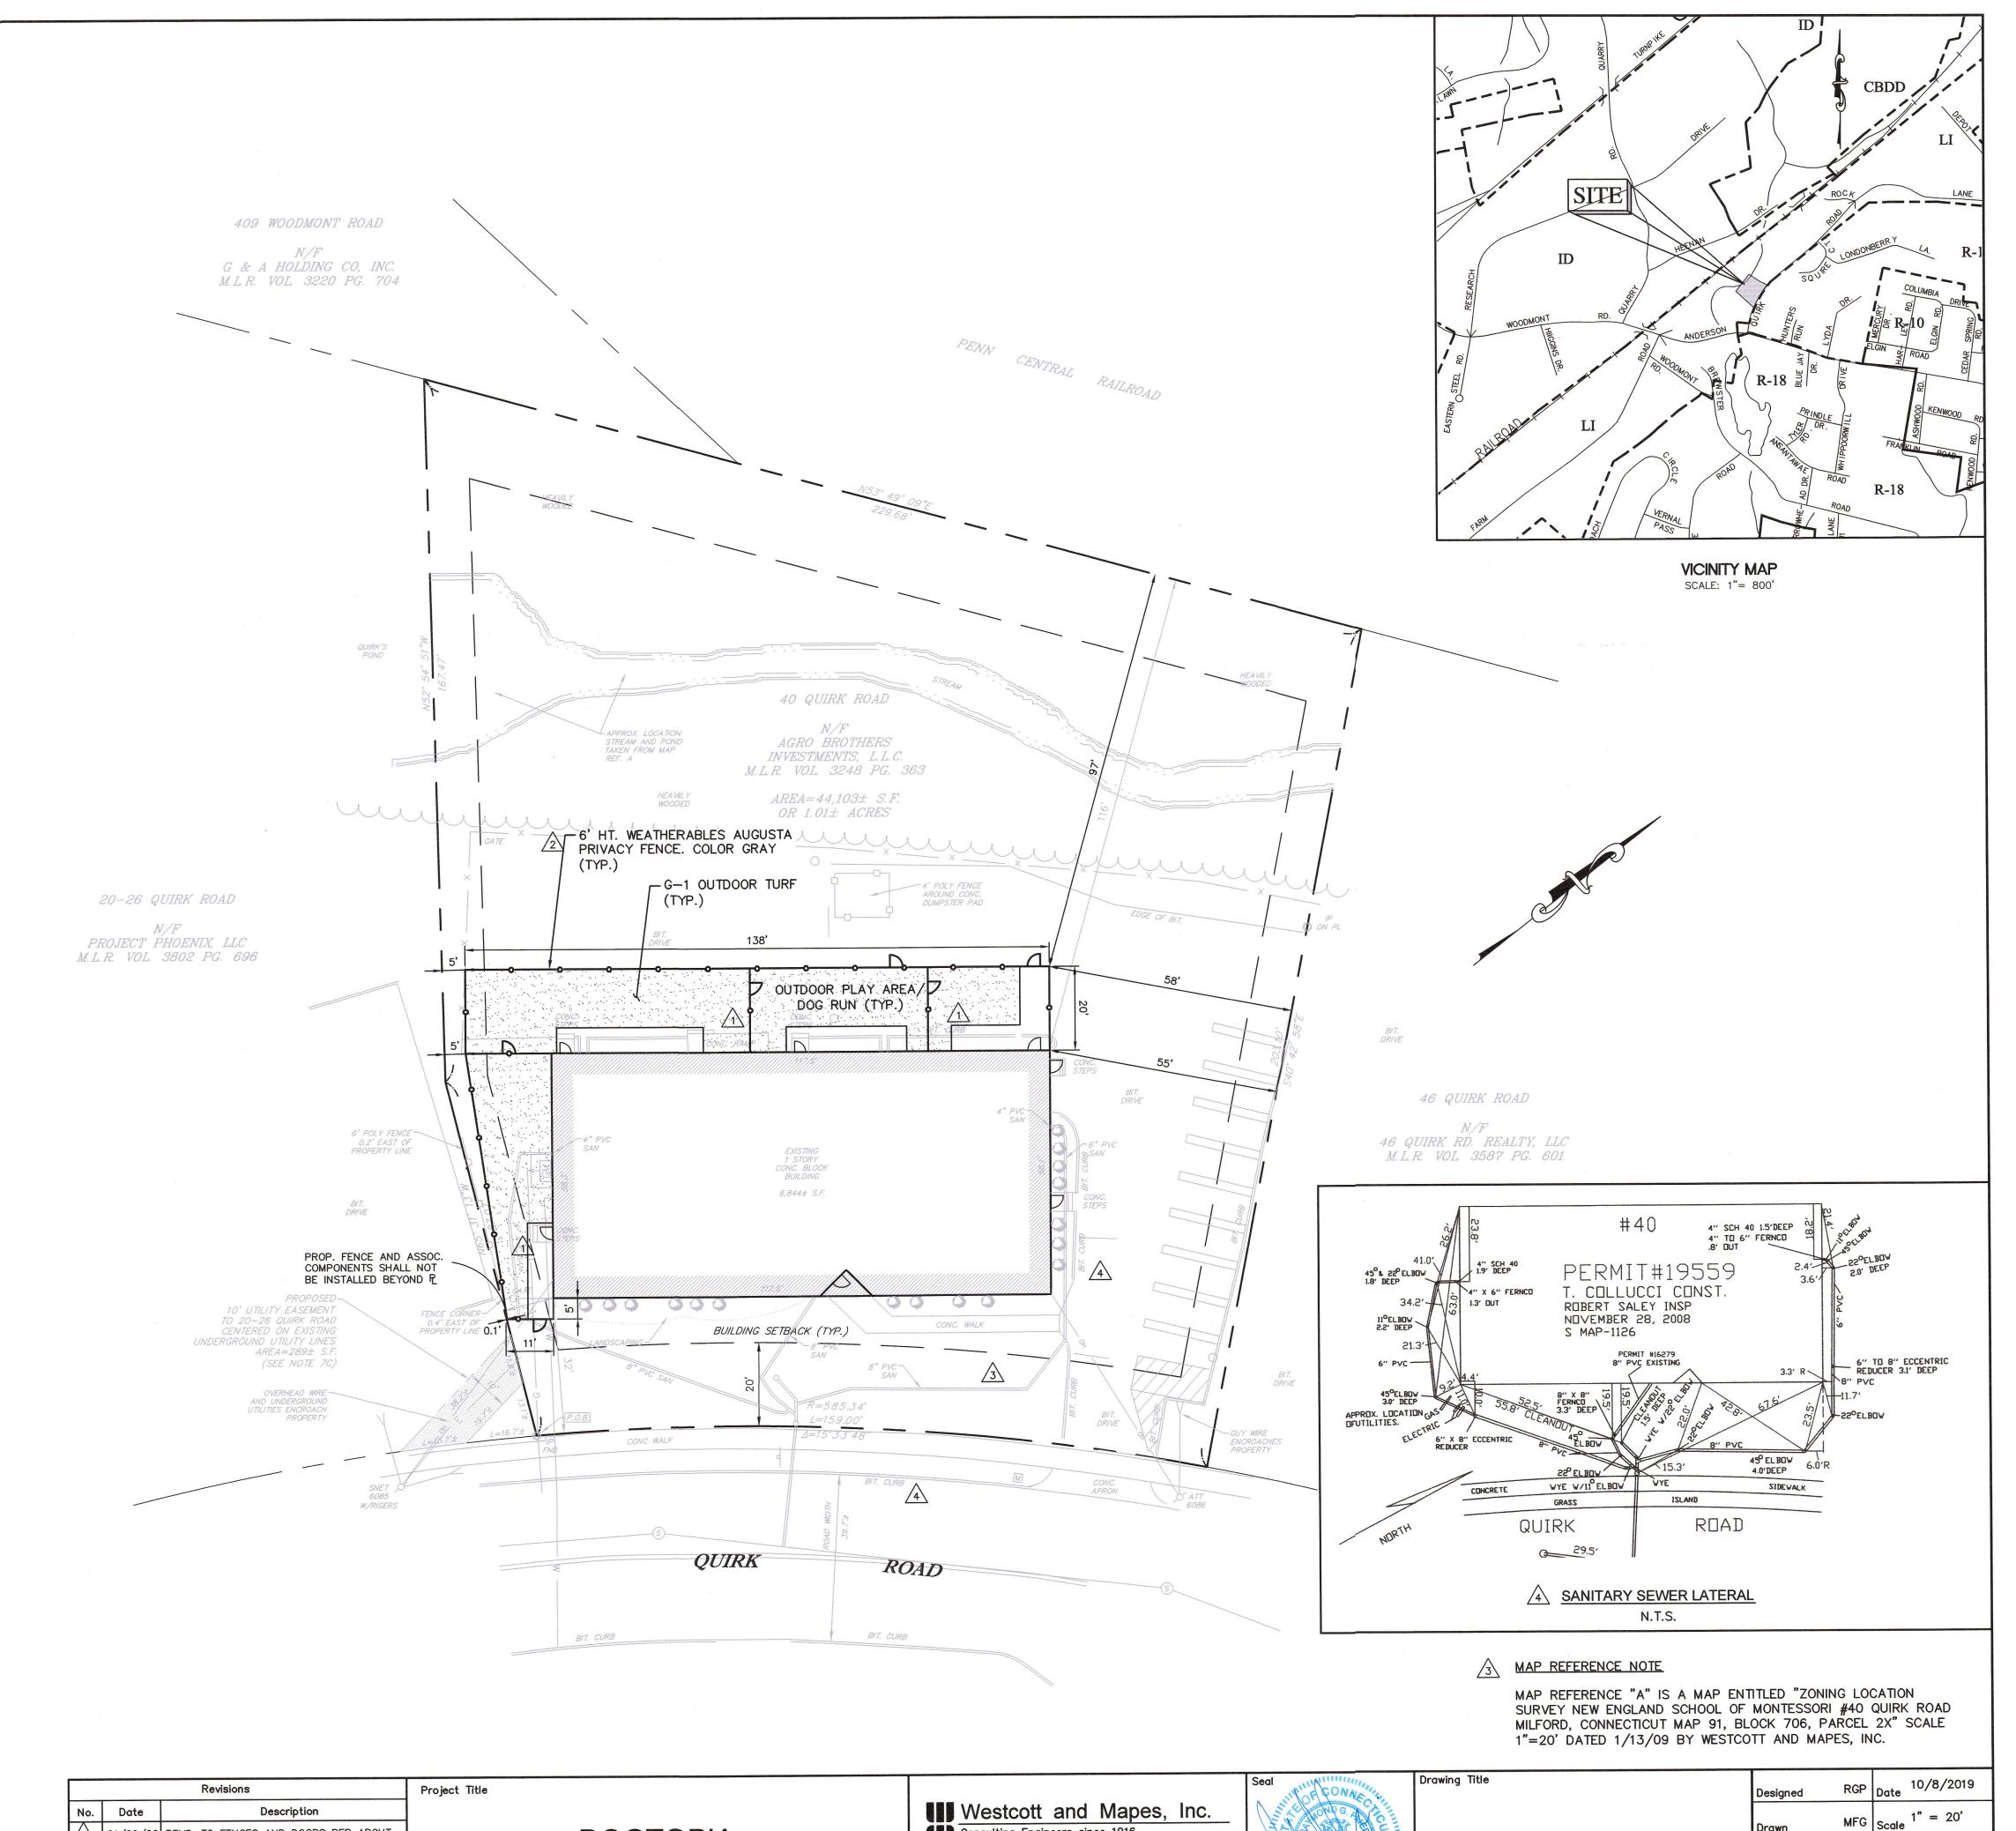

Consulting Engineers since 1916

142 Temple Street

New Haven, CT 06510

TEL (203) 789-1260 • FAX (203) 789-8261

E-mail address: info@westcottandmapes.com

SITE PLAN

Approved

Project No.

File Name

20-512-1

20-512-11 SITE

DOGTOPIA

40 QUIRK ROAD

MILFORD, CONNECTICUT

NOTES:

* DEFER TO LEGAL COUNSEL/ZONING APPROVAL OF PROPOSED USE.

GENERAL NOTES

- 1. THE SUBJECT PROPERTY IS LOCATED AT 40 QUIRK ROAD, MILFORD, CONNECTICUT. THE BACKGROUND CONDITIONS SHOWN HERE—ON ARE FROM A MAP ENTITLED "PROPERTY OF AGRO BROTHERS INVESTMENTS,LLC, 40 QUIRK ROAD, MILFORD, CONNECTICUT, PROPERTY SURVEY, SHEET 1 OF 1, SCALE 1"=20", DATED 09/17/2—19" PREPARED BY WESTCOTT AND MAPES, INC.
- 2. THE PURPOSE OF THE PLAN SET IS TO PROVIDE BASIC SITE, ZONING INFORMATION FOR MUNICIPAL OFFICIAL'S REVIEW.
- PROPERTY.

 4. THE CONTRACTOR SHALL FAMILIARIZE HIMSELF WITH THE SITE CONDITIONS AND PERFORM FIELD INVESTIGATIONS PRIOR TO COMMENCING HIS WORK.


3. THE CONTRACTOR SHALL MAINTAIN ALL OF HIS OPERATIONS AND WORK WITHIN THE LIMITS OF THE

- 5. THE CONTRACTOR SHALL INSTALL AND MAINTAIN TEMPORARY EROSION AND SEDIMENTATION CONTROL MEASURES WHERE APPLICABLE IN ACCORDANCE WITH THE STATE OF CONNECTICUT GUIDELINES FOR SOIL EROSION AND SEDIMENT CONTROL MANUAL, LATEST EDITION.
- 6. THE CONTRACTOR SHALL CONTACT "CALL BEFORE YOU DIG" 811" AT LEAST SEVENTY-TWO (72) HOURS PRIOR TO COMMENCING WORK.
- 7. EXISTING UTILITIES MAY BE SHOWN ACCORDING TO REFERENCE PLANS WHEN AVAILABLE, SKETCHES, TESTIMONY AND/OR FIELD EVIDENCE AND MUST BE CONSIDERED APPROXIMATE IN NATURE. THE CONTRACTOR SHALL CONFIRM ACTUAL LOCATIONS AND ELEVATIONS OF EXISTING UTILITIES IF AND WHERE NECESSARY. THERE MAYBE OTHER UTILITIES THAT EXIST NOT SHOWN AND UNKNOWN TO THE AUTHOR OF THESE PLANS.
- 8. THE CONTRACTOR IS RESPONSIBLE FOR COORDINATING ALL WORK REGARDING THIS PROJECT AND FOR OBTAINING ANY NECESSARY PERMITS RELATED TO HIS CONSTRUCTION ACTIVITIES.
- 9. THE CONTRACTOR SHALL BE RESPONSIBLE FOR ESTABLISHING AND MAINTAINING A SAFE ENVIRONMENT FOR WORKERS, PEDESTRIANS AND VEHICULAR TRAFFIC THROUGHOUT THE CONSTRUCTION PERIOD, AND COORDINATE HIS EFFORTS AND HIS SEQUENCE AND TIMING OF OPERATIONS WITH THE PROPERTY OWNER.
- 10. THE CONTRACTOR IS RESPONSIBLE FOR THE PROPER DEMOLITION, REMOVAL, AND OFF-SITE DISPOSAL OF EXISTING FEATURES, WITHIN THE LIMITS OF WORK, AS REQUIRED FOR THE INSTALLATION OF NEW WORK.

 11. UNLESS OTHERWISE SPECIFIED, THE METHODS AND MATERIALS FOR THIS PROJECT SHALL CONFORM TO
- 11. UNLESS OTHERWISE SPECIFIED, THE METHODS AND MATERIALS FOR THIS PROJECT SHALL CONFORM TO THE CONNECTICUT DOT STANDARD SPECIFICATIONS FOR ROADS, BRIDGES AND INCIDENTAL CONSTRUCTION FORM 817 AND AS AMENDED.
- 12. SANITARY SEWER SERVICE PIPES DEPICTED ON THIS PLAN WERE DIGITIZED FROM THE FIELD TIES SKETCH PROVIDED BY THE CITY OF MILFORD ENGINEERING DEPARTMENT, PERMIT #19559, PERFORMED BY T. COLLUCCI CONST., ROBERT SALEY INSPECTOR DATED NOVEMBER 28, 2008. SEWER MAP S 1126.

THE INFORMATION CONTAINED HEREIN IS THE PROPRIETARY AND CONFIDENTIAL PROPERTY OF WESTCOTT AND MAPES, INC. REPRODUCTIONS, PUBLICATION, DISTRIBUTION OR DUPLICATION IN WHOLE OR IN PART REQUIRES THE WRITTEN PERMISSION OF WESTCOTT AND MAPES, INC. THIS DOCUMENT AND COPIES THEREOF ARE VALID ONLY IF THEY BEAR THE LIVE SIGNATURE AND SEAL OF THE DESIGNATED LICENSED PROFESSIONAL. UNAUTHORIZED USE, DISTRIBUTION AND/OR DUPLICATION OF SAID INFORMATION WILL RESULT IN SUBSTANTIAL DAMAGE TO WESTCOTT


AND MAPES, INC. FOR WHICH YOU MAY BE LIABLE.

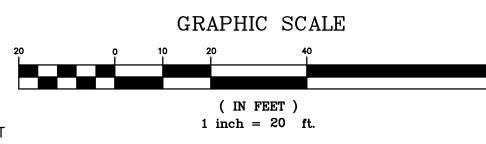

01/29/20 REVS. TO FENCES AND DOORS PER ARCHT.

03/17/20 REV. EX. SAN. AND ADDED NOTES

03/02/20 REV. PROP. FENCE HT.

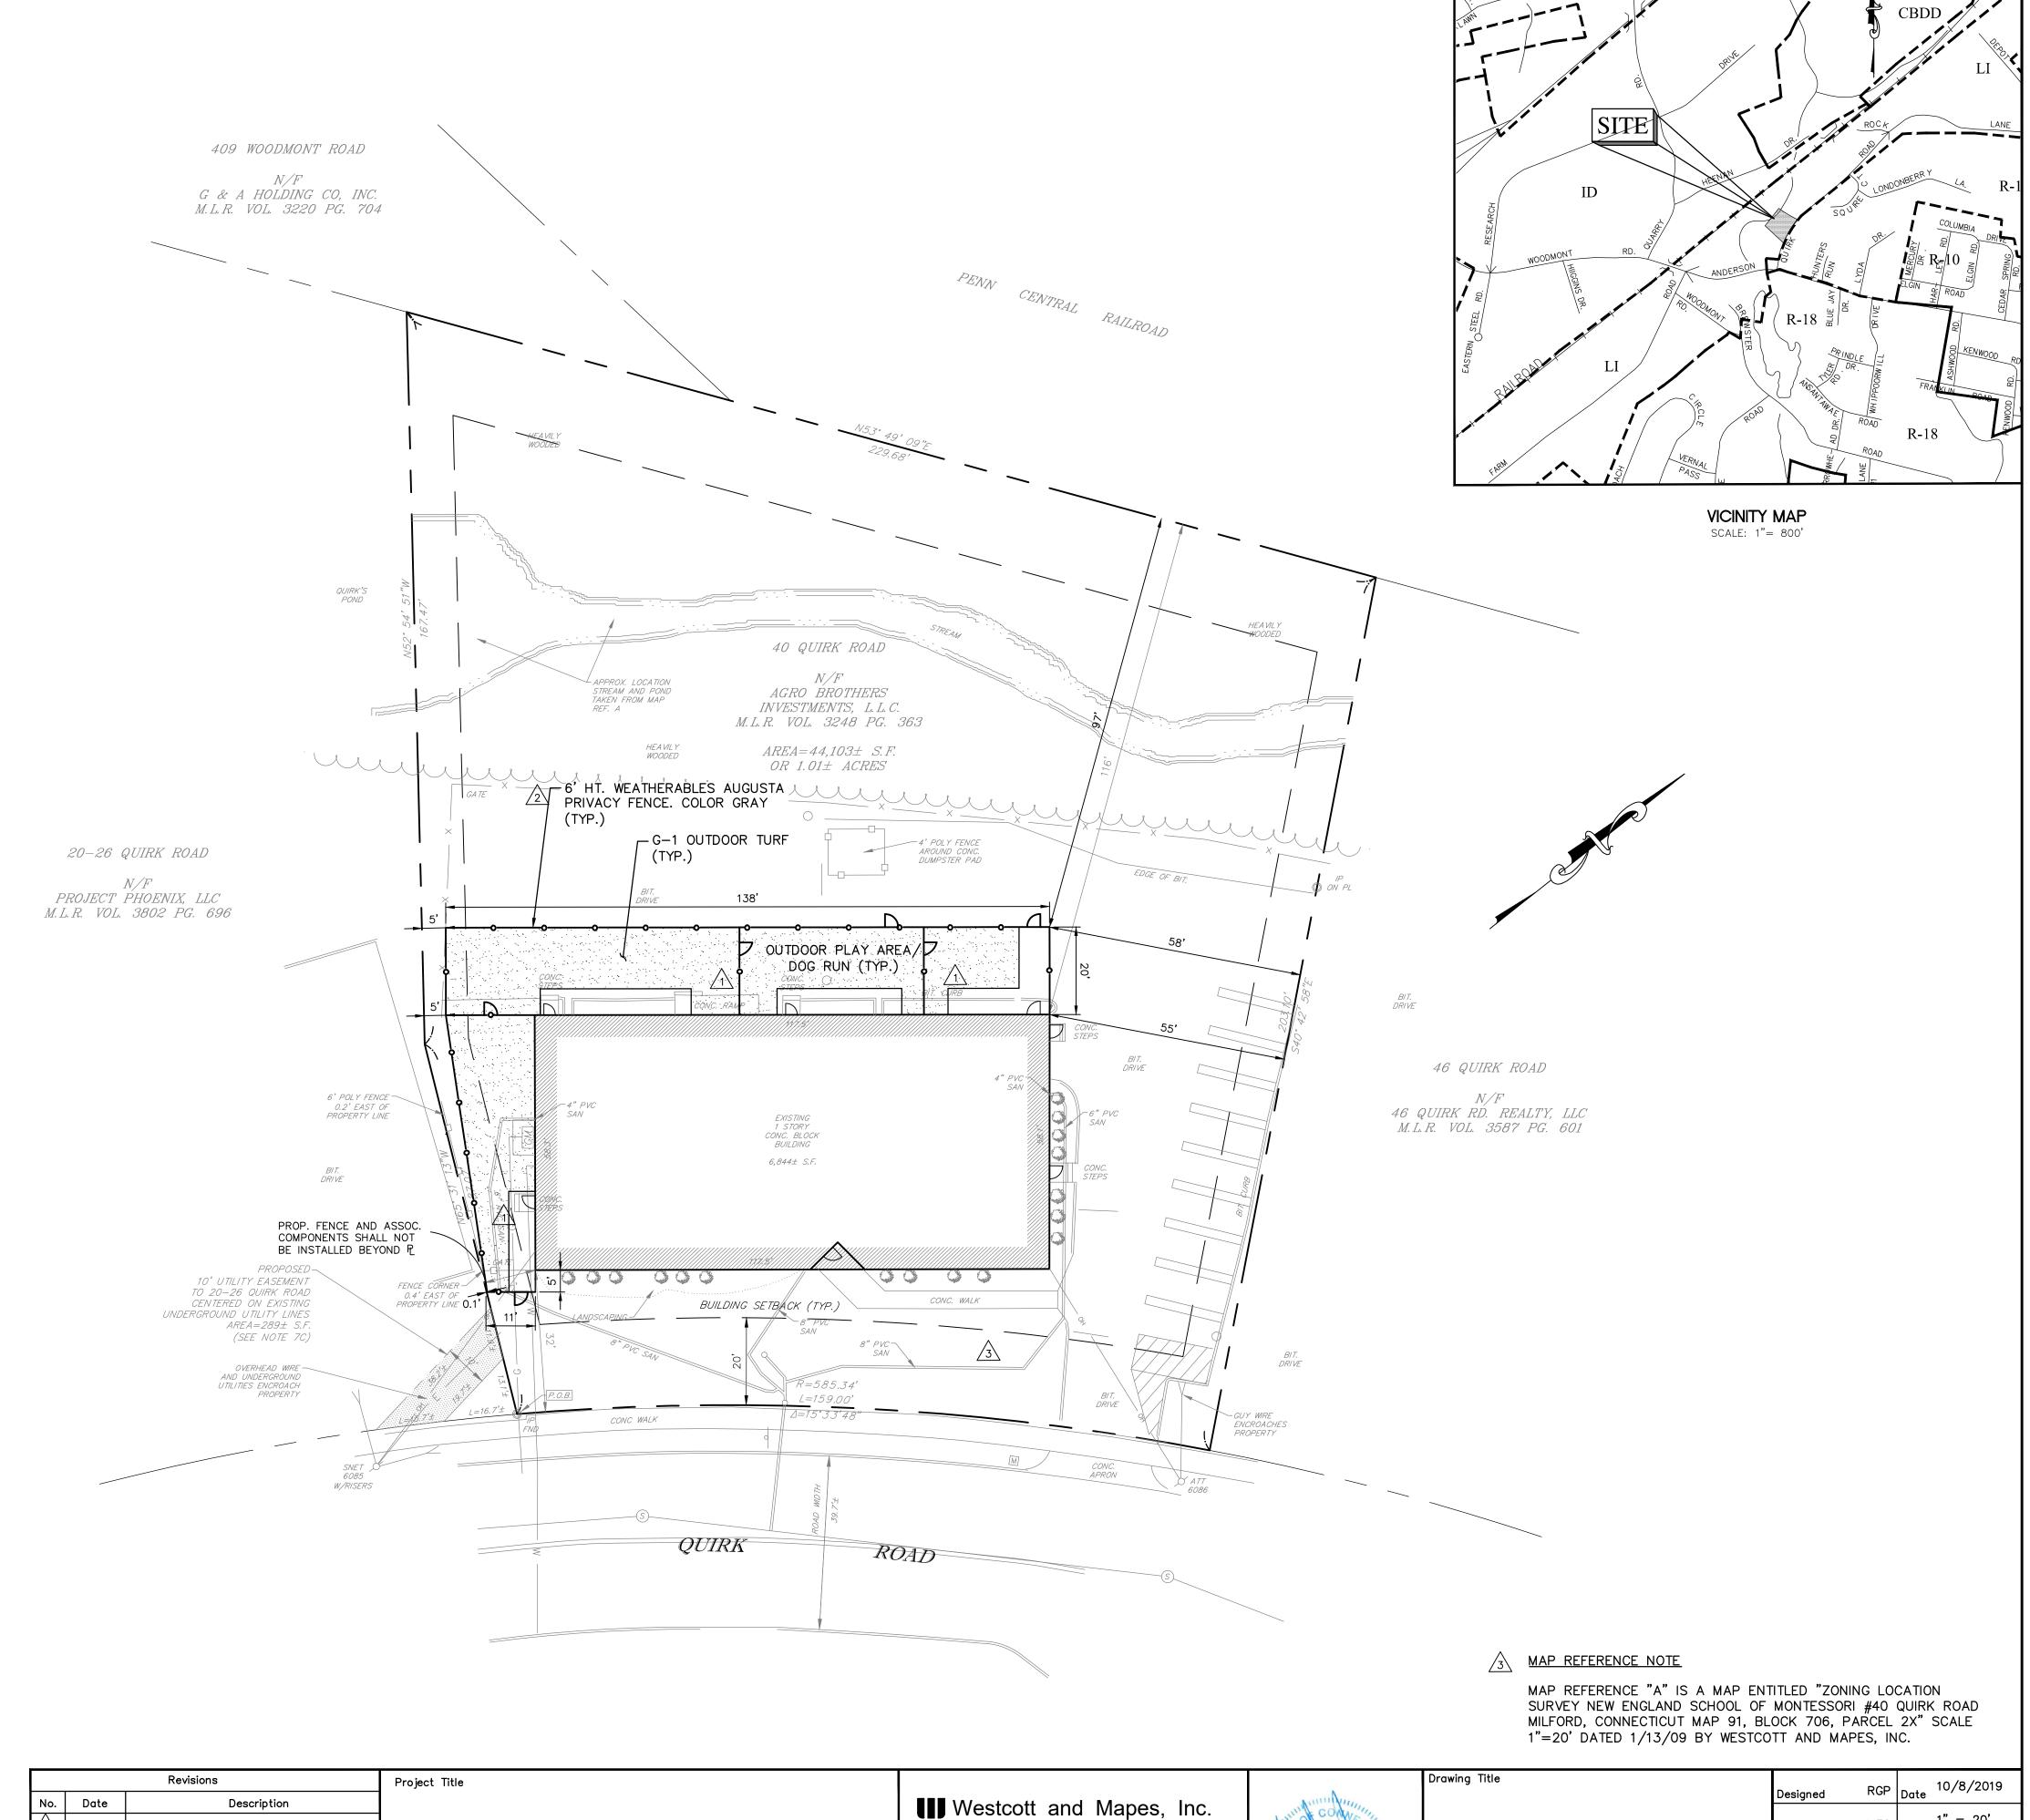

Consulting Engineers since 1916

142 Temple Street

New Haven, CT 06510

TEL (203) 789-1260 • FAX (203) 789-8261

E-mail address: info@westcottandmapes.com

DOGTOPIA

40 QUIRK ROAD

MILFORD, CONNECTICUT

 $| MFG |_{Scale} 1" = 20'$


20-512-11


20-512-11 SITE

Project No.

SITE PLAN

היי אינויי מי מי מי מימימי מדמיו מממ / היי אינויי

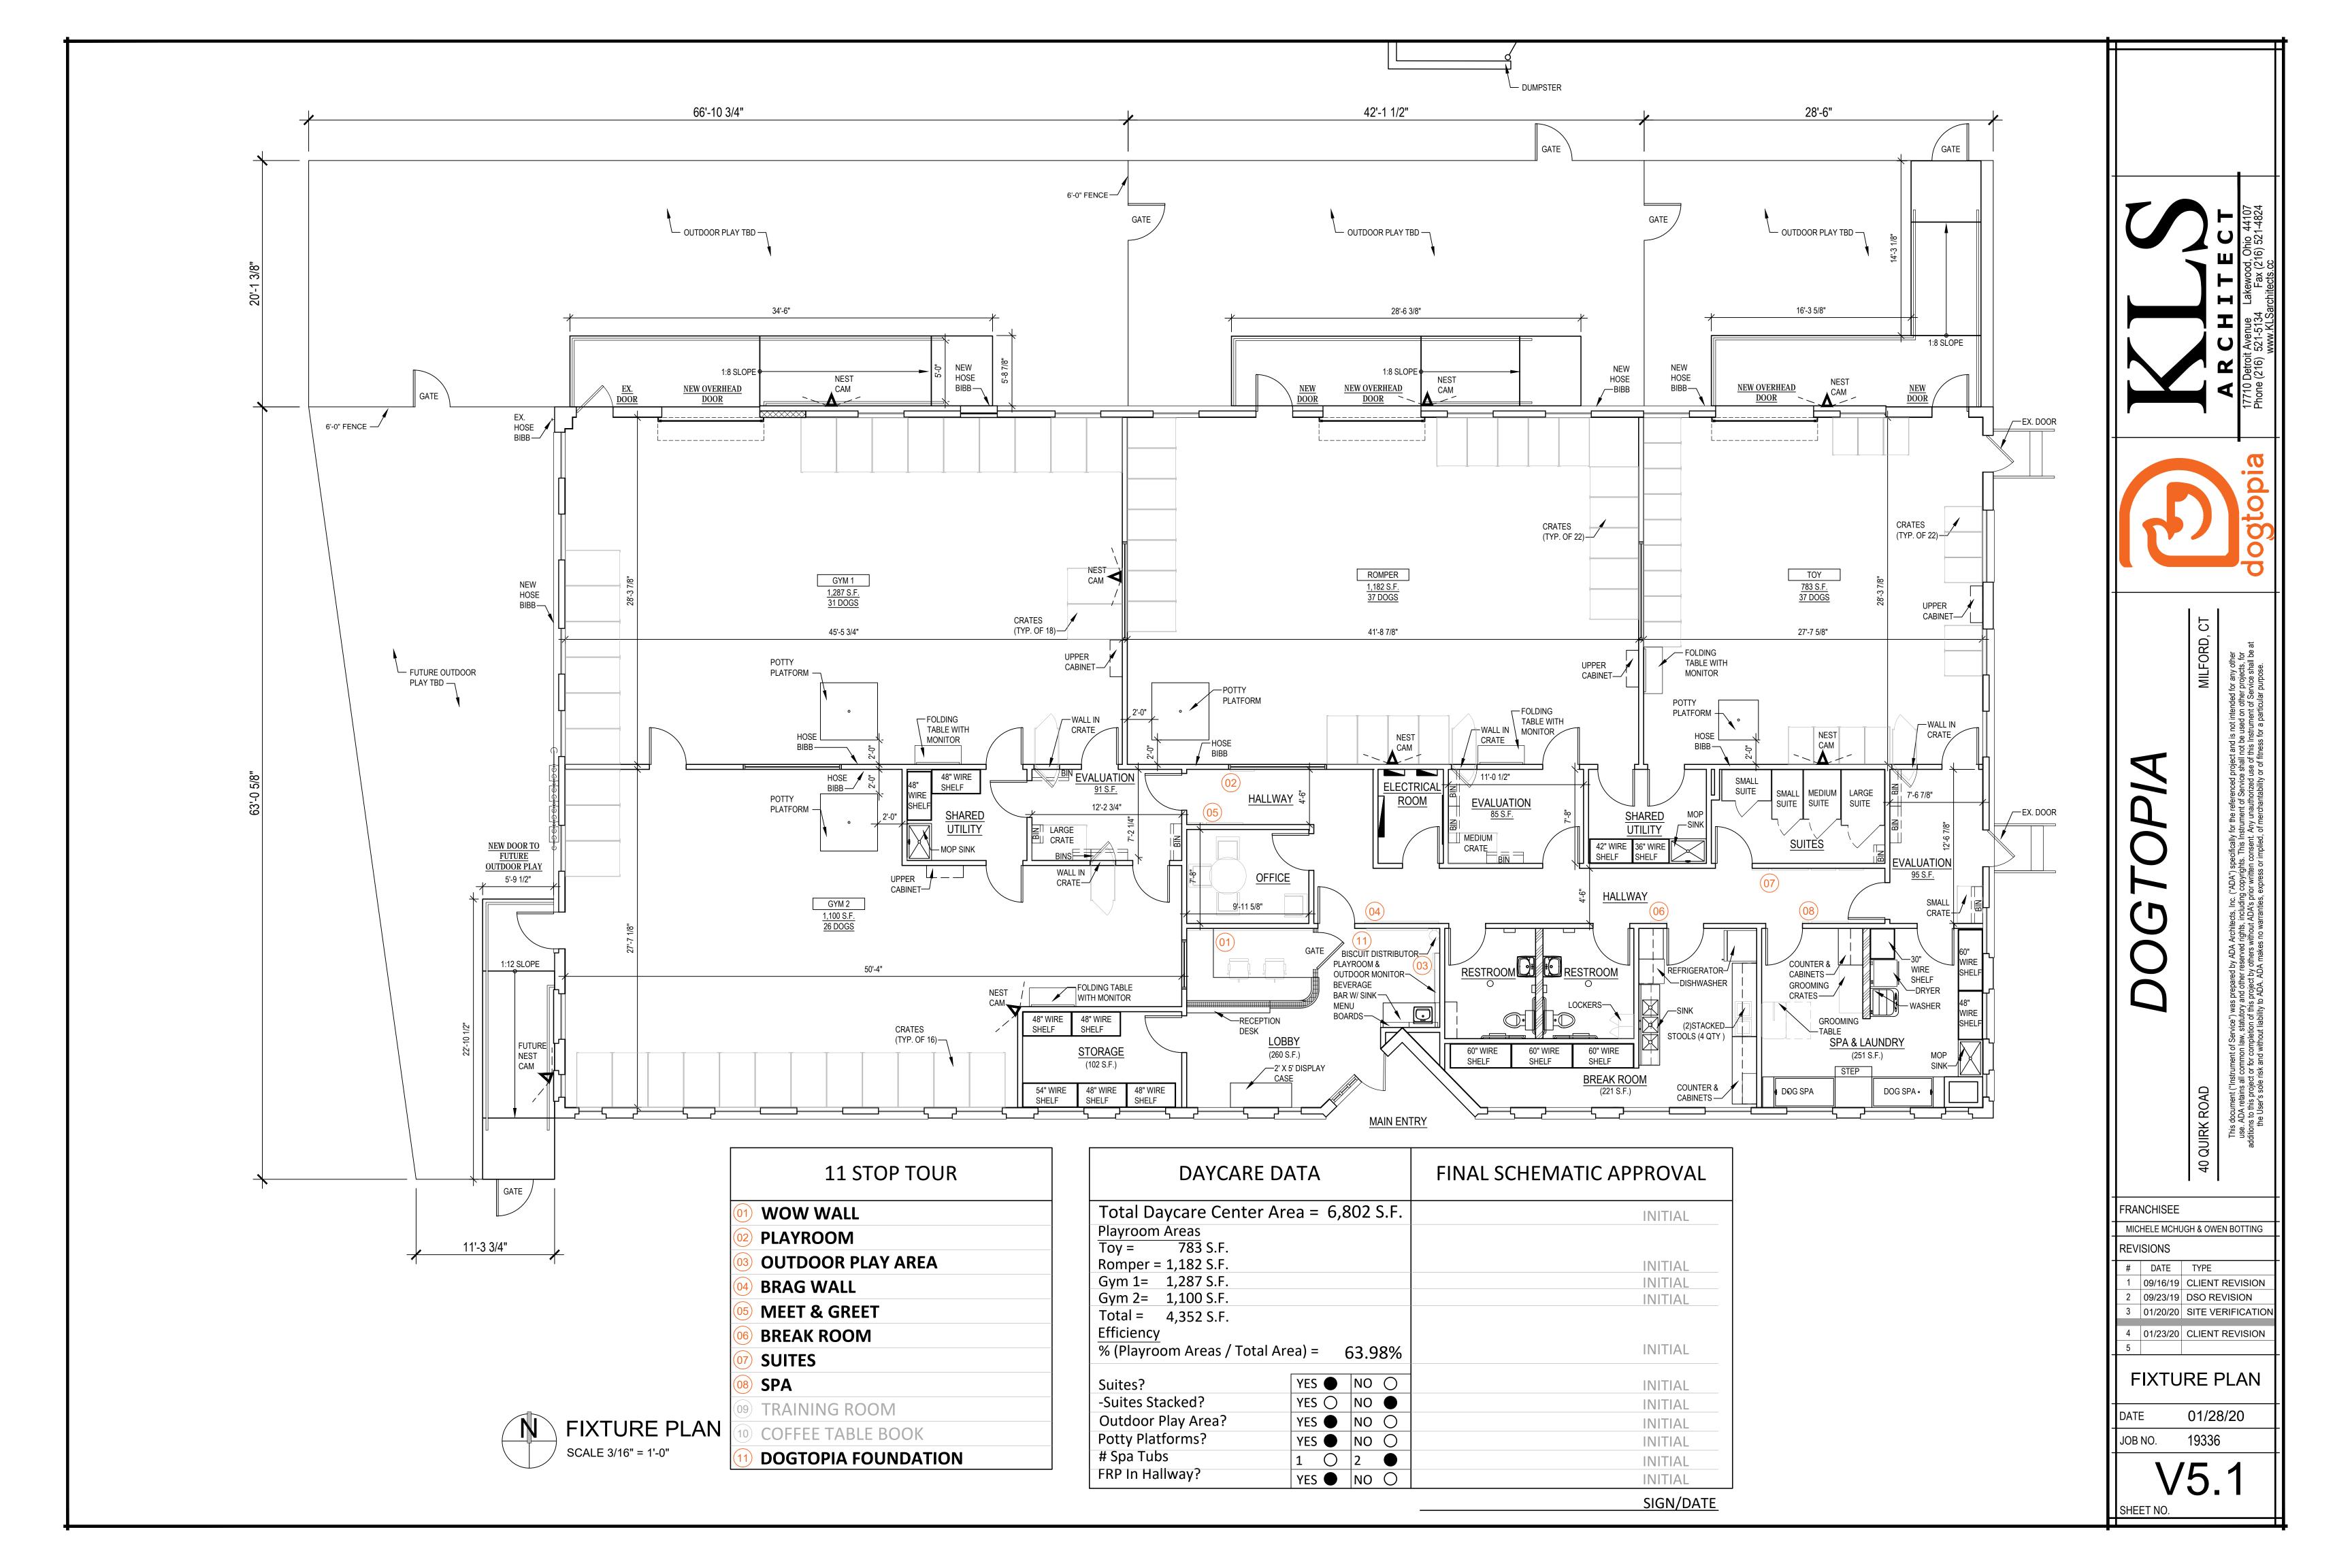

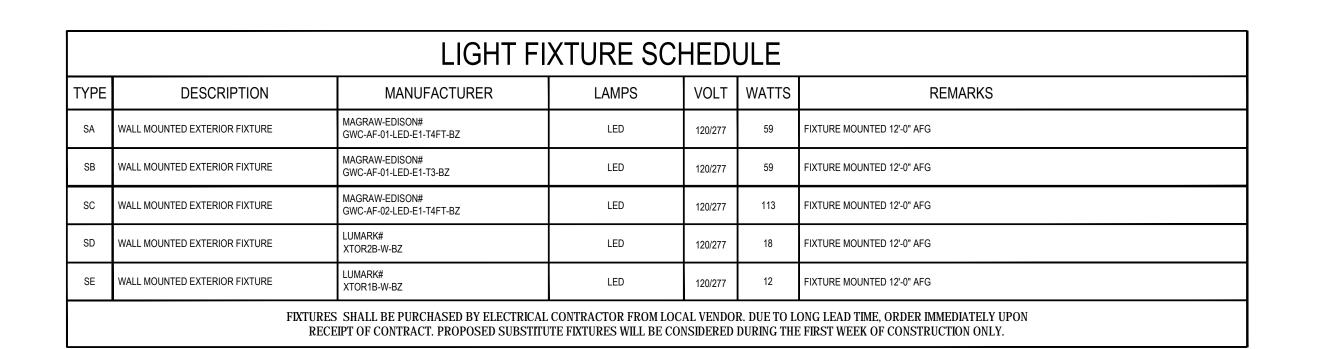

STATISTICS	(VALUES ARE MAINTAINED)						
Description	Avg	Max	Min	Max/Min	Avg/Min		
PARKING FIELD	2.7 fc	13.6 fc	0.2 fc	68.0:1	13.5:1		

A R C H I T E C T



D, CT dogto

MILF itects, Inc. ("ADA") specifically for the referenced project and is not intended for any o

K ROAD
s document ("Instrument of Service") was prepared by ADA A
. ADA retains all common law, statutory and other reserved
ins to this project or for completion of this project by others w

FRANCHISEE

MICHELE MCHUGH & OWEN BOTTING

REVISIONS


DATE TYPE
1 2 3 4 5 5


PHOTOMETRICS
PLAN

DATE 09/13/19


JOB NO. 19336

PH1.0

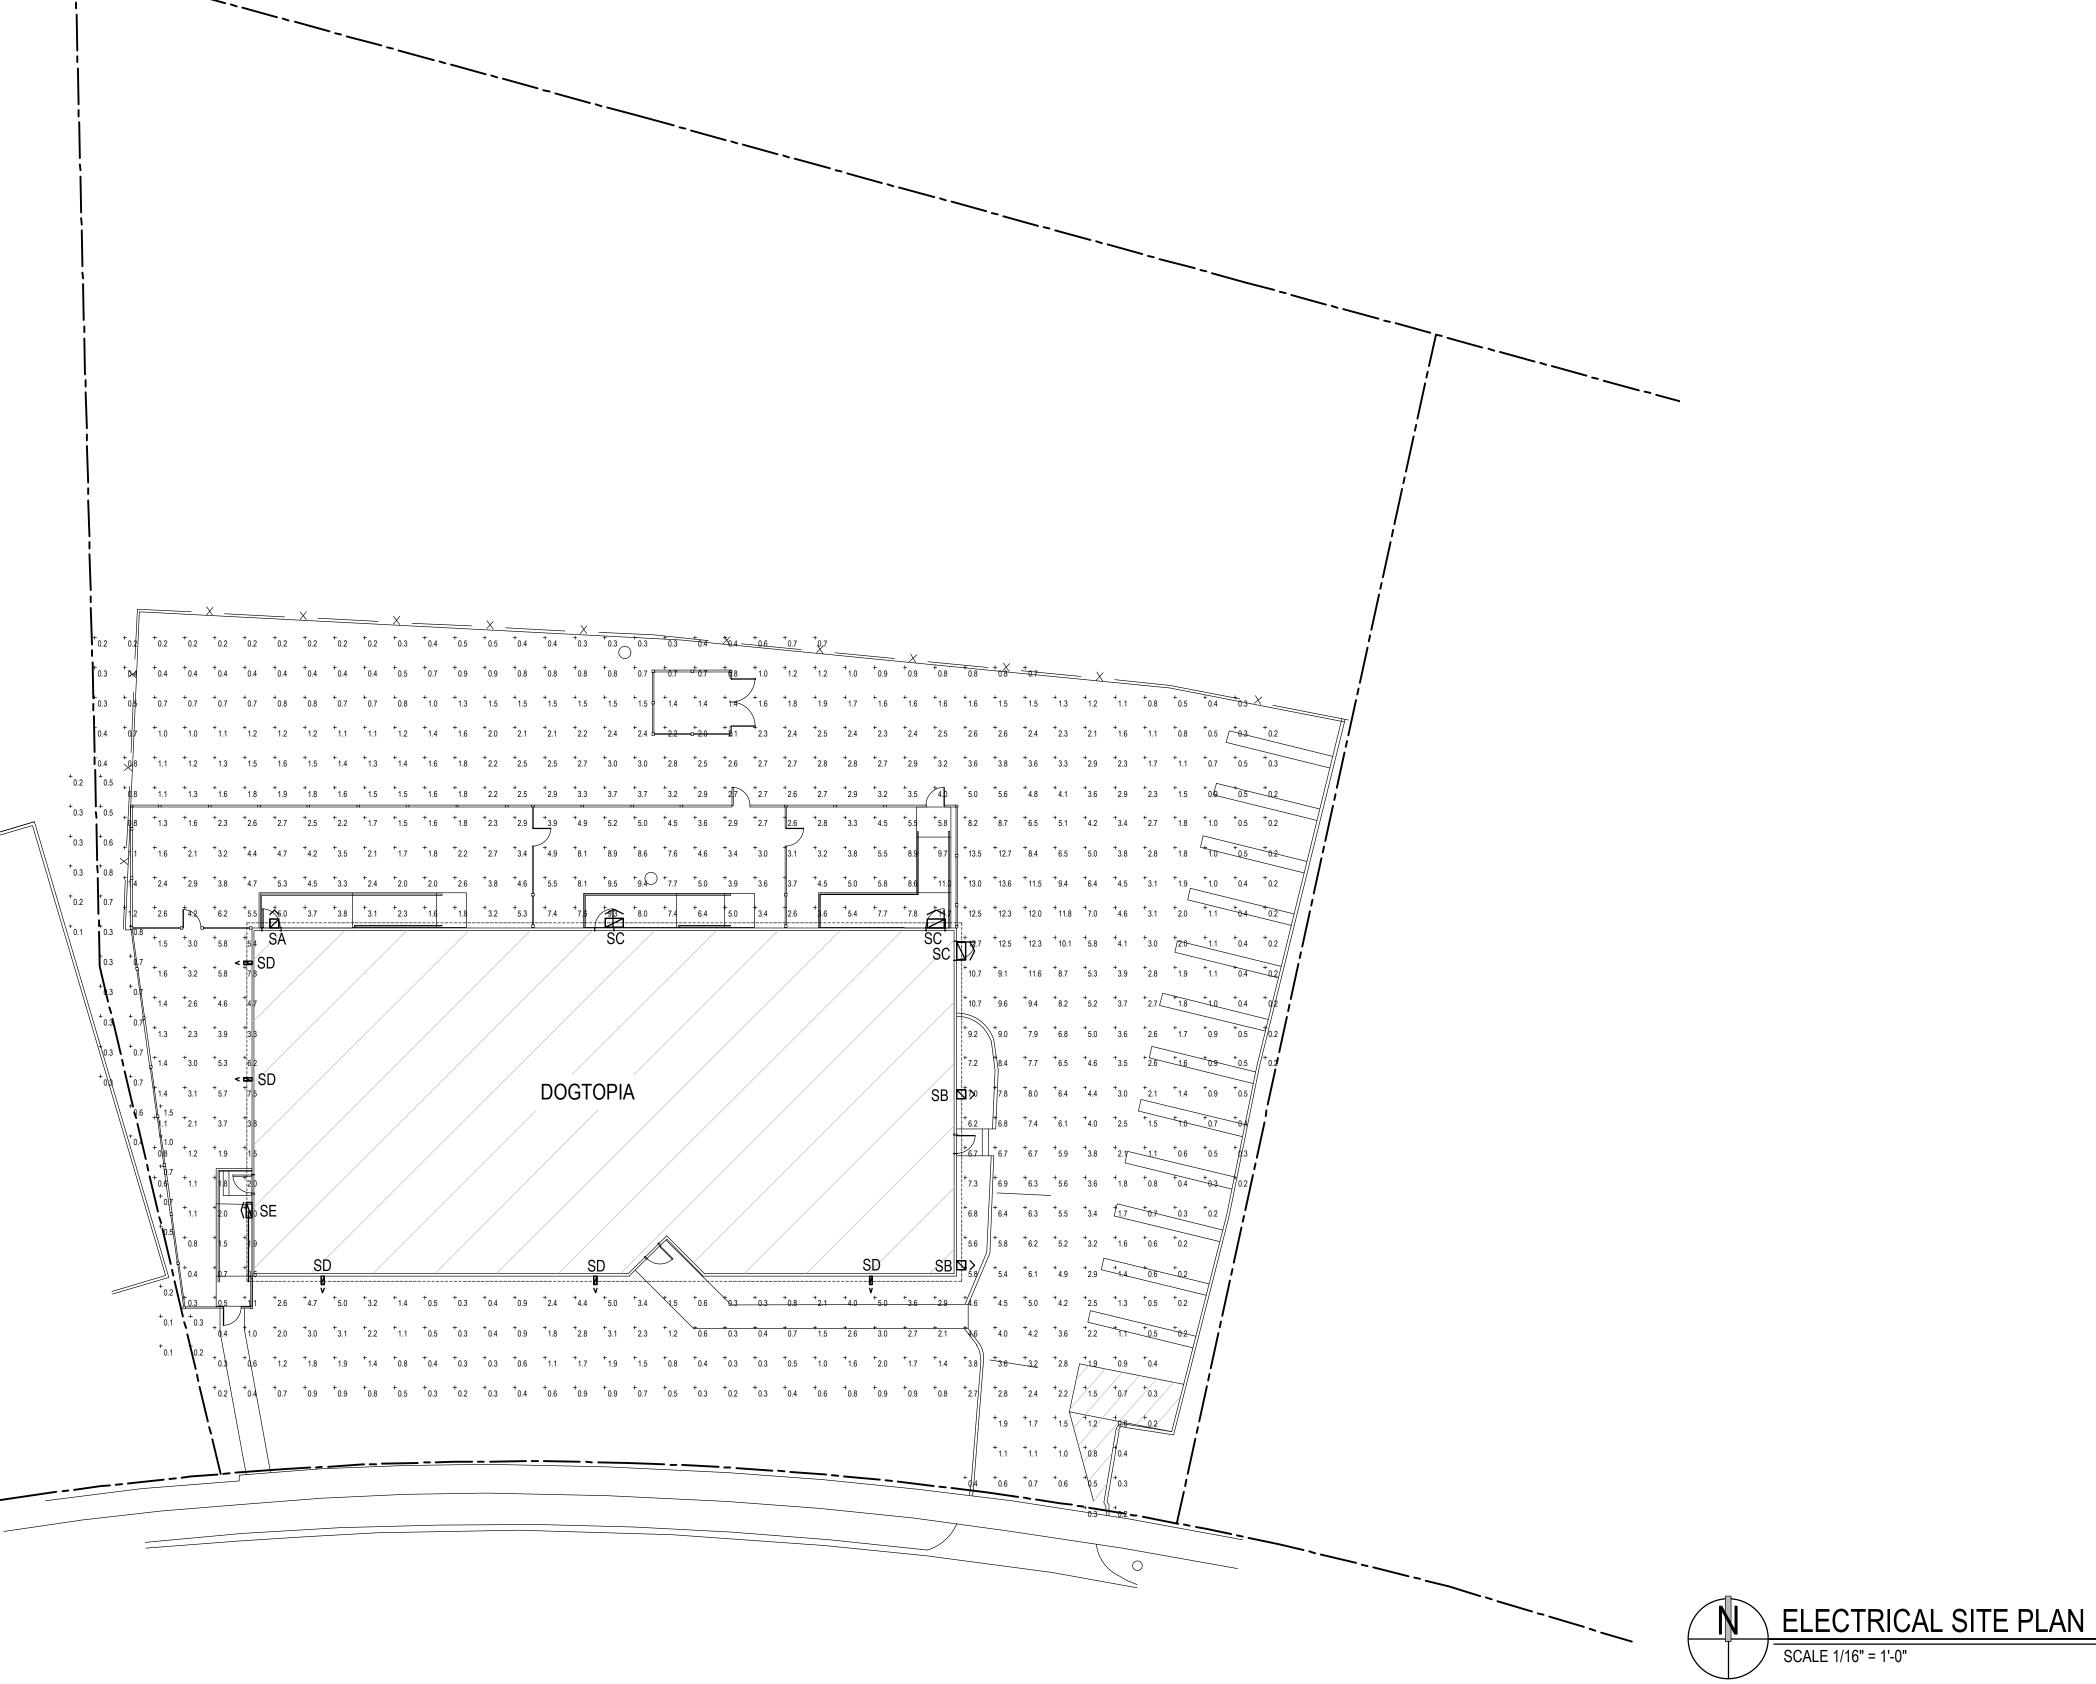


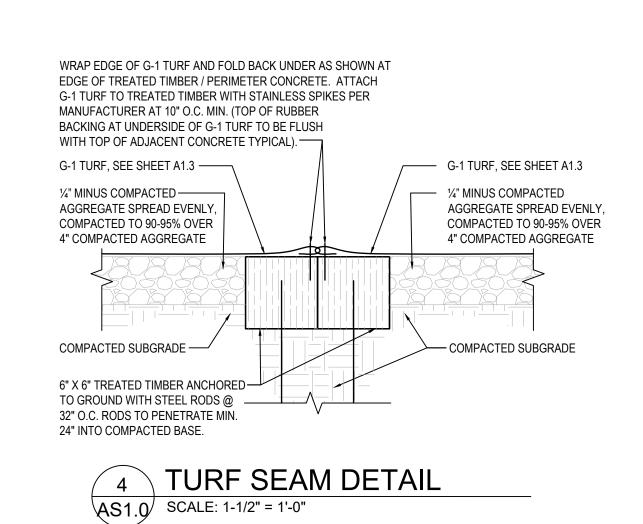




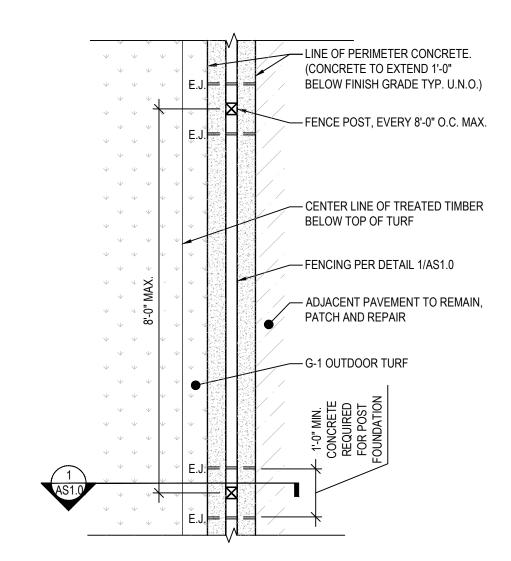



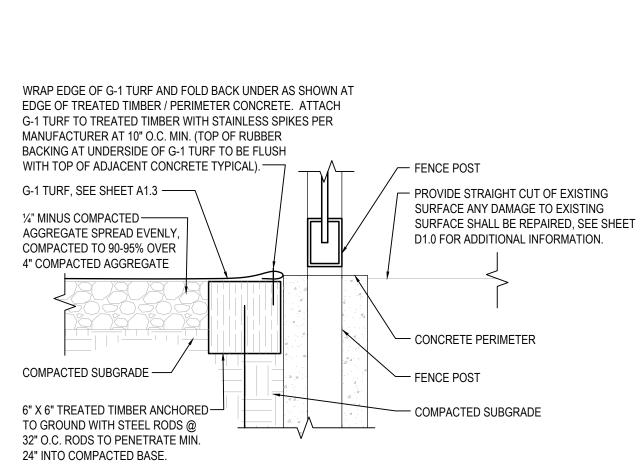

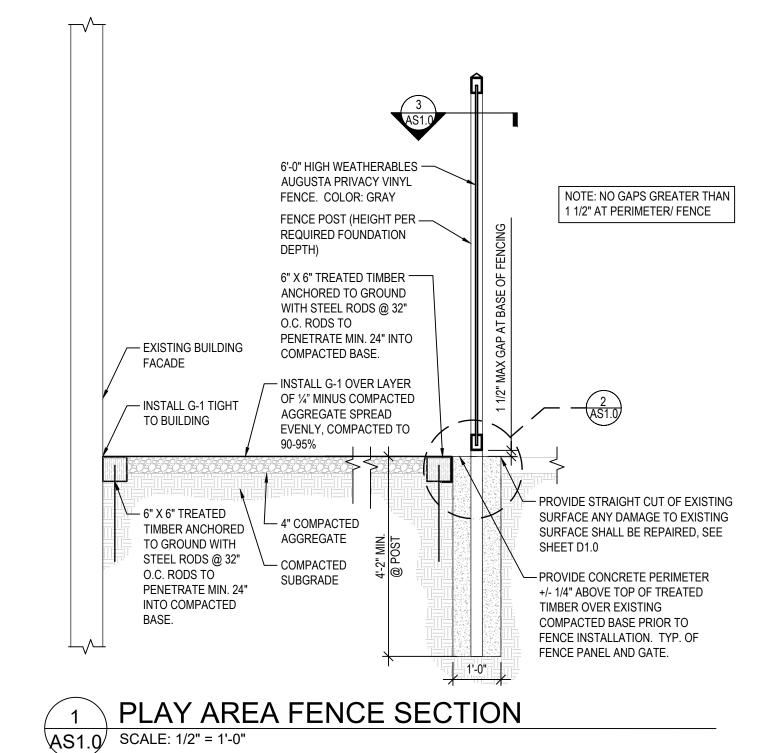



2 TURF PERIMETER DETAIL
AS1.0 SCALE: 1-1/2" = 1'-0"